\\Bdfiler\construction\58 - Westgate-Edmonds\ACTIVE\58 wall for SKP - CPS MODS - 2400 STUDY - 2012.03.20.dwg, 11x17, 3/27/2012 12:52:44 PM, nickl, Tabloid, 1:1

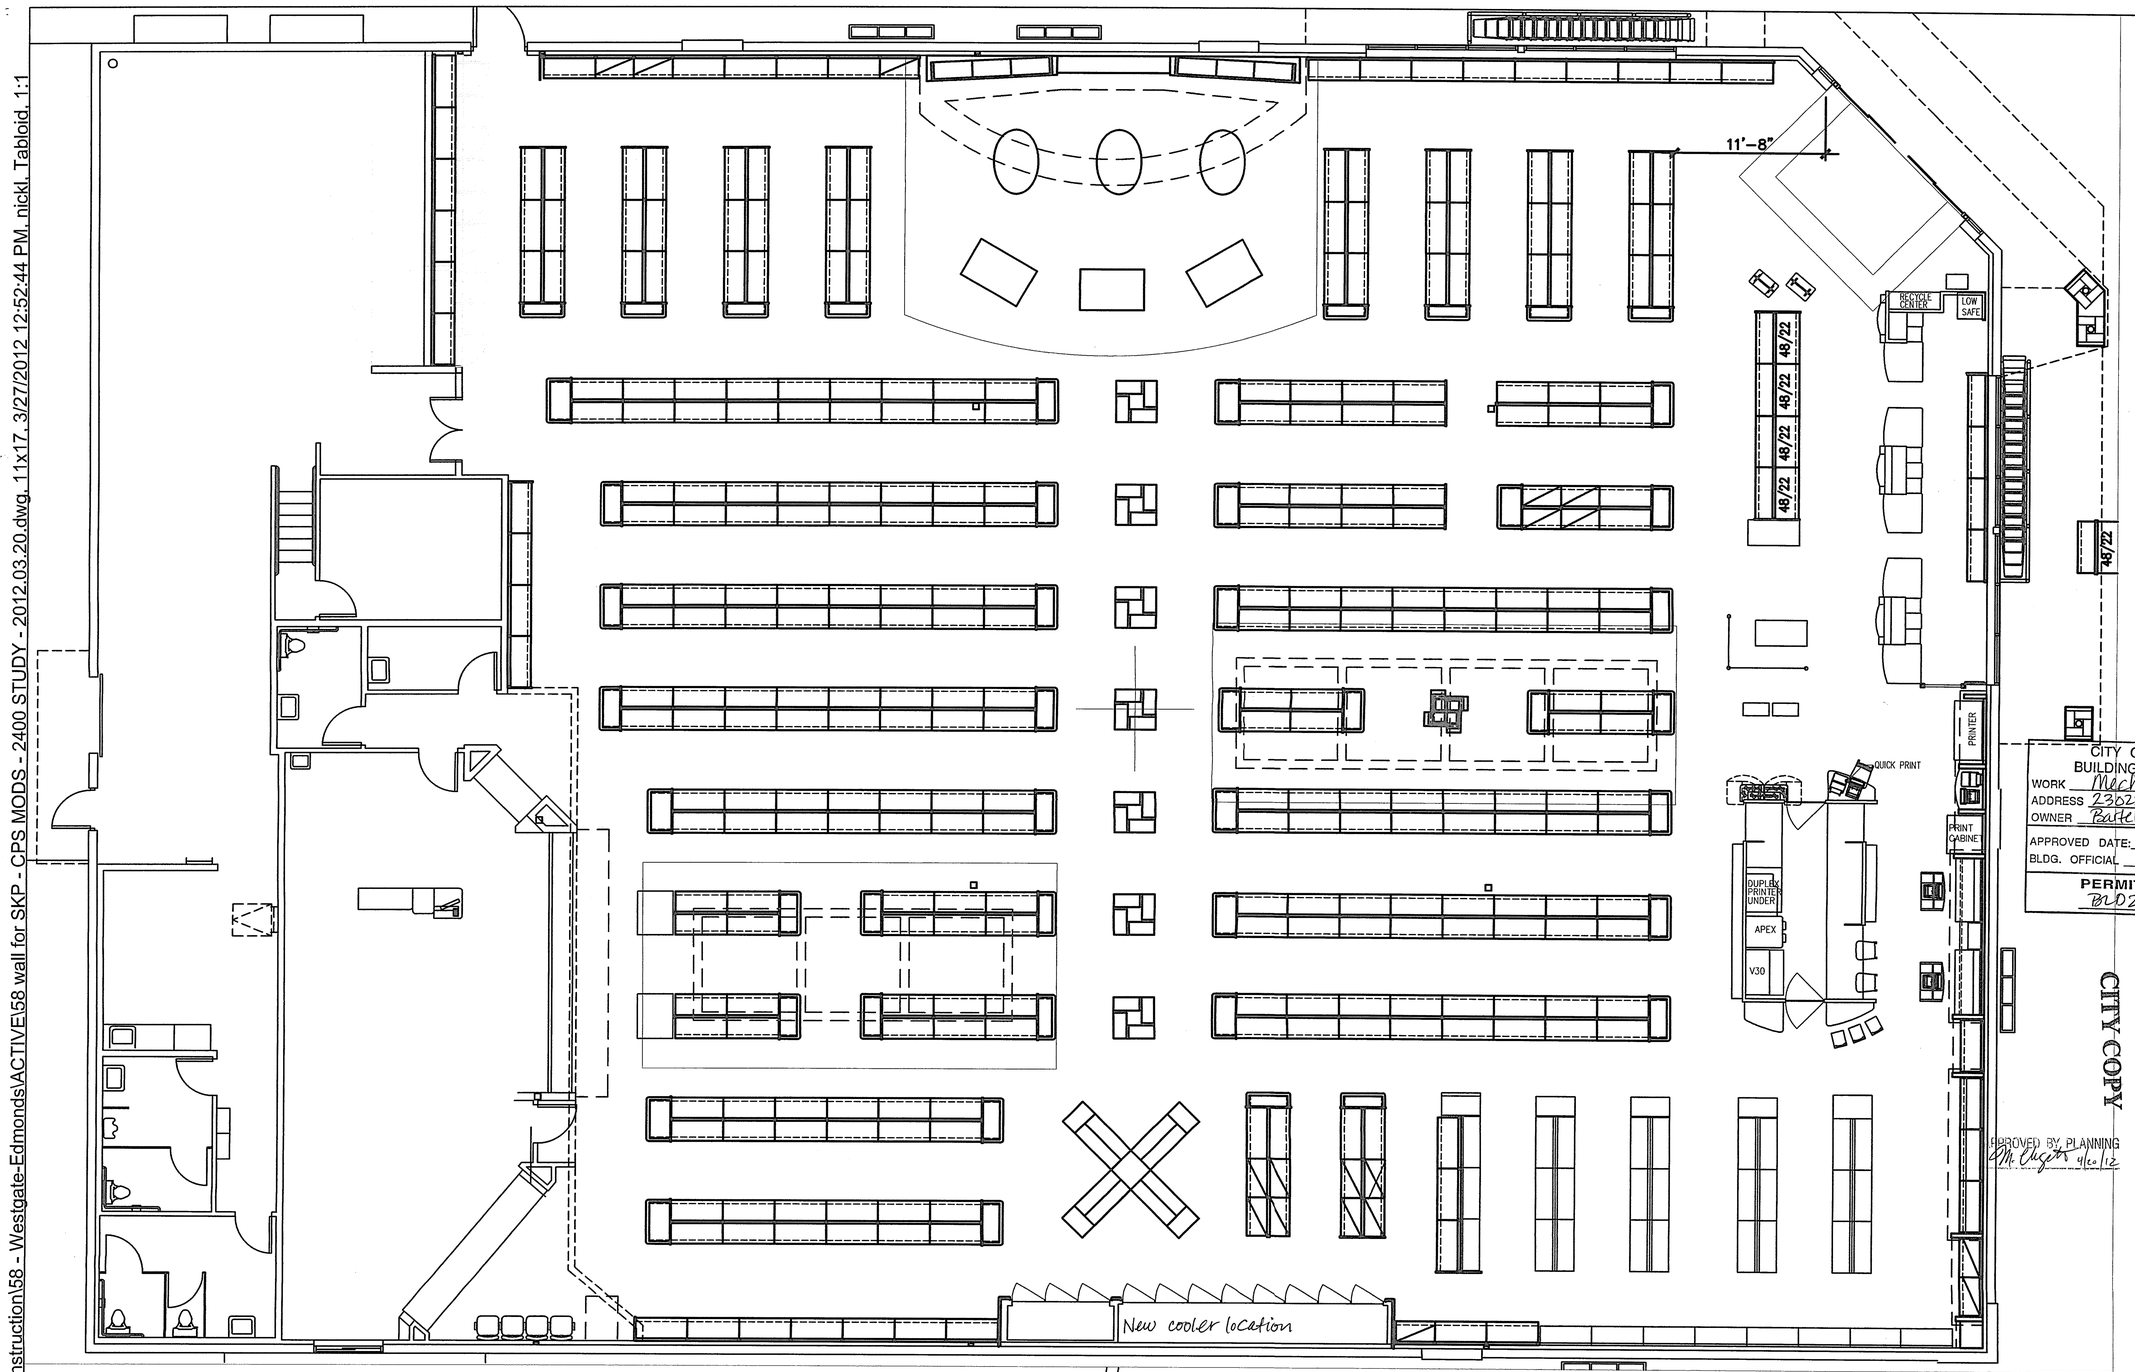

#58 FLOORPLAN 03.12.2012

SCALE: NOT TO SCALE

RECEIVED
APR 12 2012
DEVELOPMENT SERVICES COUNTER

CITY OF EDMONDS
BUILDING DEPARTMENT
WORK Mechanical - Coolers + Condensers
ADDRESS 23028 100th Ave W
OWNER Bartell Drugs
APPROVED DATE: 4/24/12
BLDG. OFFICIAL
PERMIT NUMBER
PRD2012-0264

CITY COPY

APPROVED BY PLANNING
4/20/12

BARTELL DRUGS
Washington's Own Druggists

MARK	DATE	DESCRIPTION
	04.02.08	MERCH UPDATES AS OF 04.02.08
	01.09.12	MERCH ON ALTERED 12.27.11 FIXTURE PLAN
	02.03.12	ALTERNATE FIXTURE PLAN STUDY
	02.24.12	REVISED ALTERNATE FIXTURE PLAN STUDY

DRAWN: NRL/RR
CHECK:
JOB NO:

58 EDMONDS BARTELL DRUGS
23028 100TH AVE WEST
EDMONDS, WASHINGTON
FOR: BARTELL DRUGS

FILE NAME: BART-MERCH 11X17 PLOT BY: NRL PLOT DATE: 09.17.08 NOTES: MERCH SET

SHEET: 1 of 2

A4.11

MERCHANDISE

City of Edmonds Building Department
APPROVED PLAN

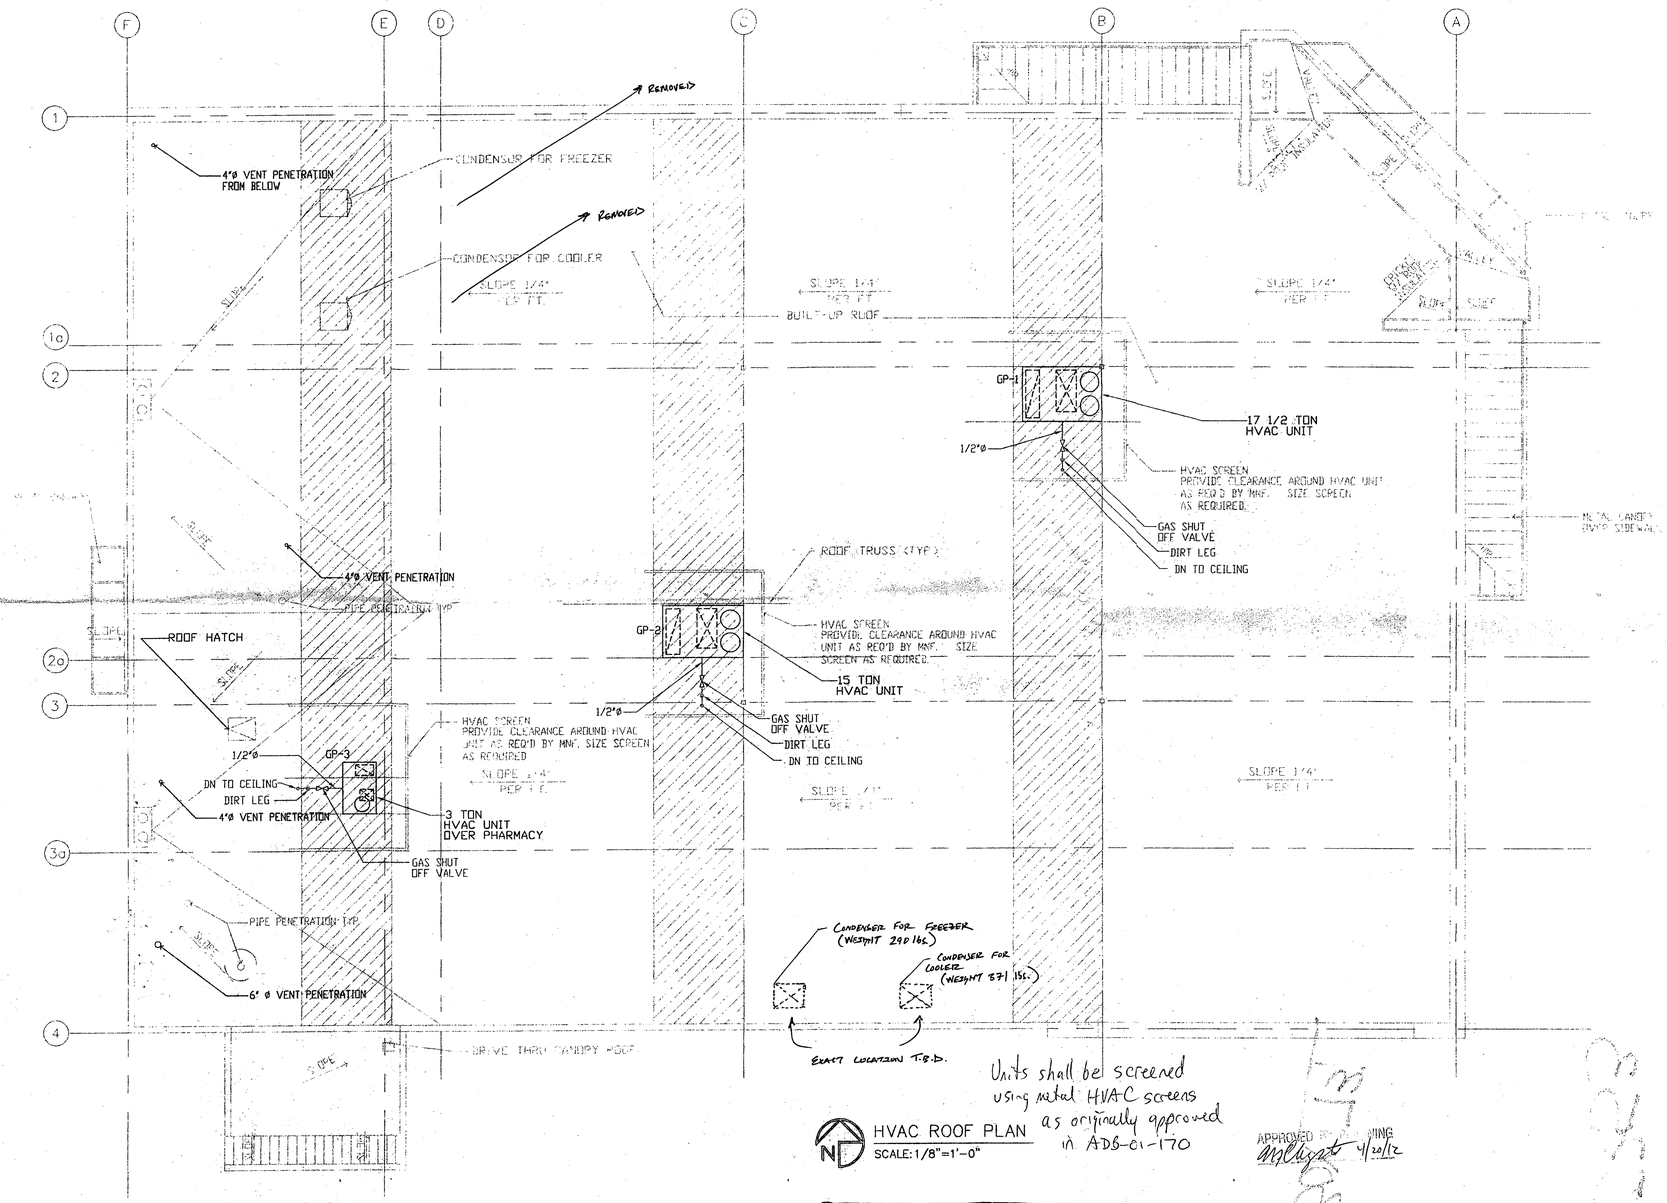

HVAC ROOF PLAN
SCALE: 1/8"=1'-0"

Units shall be screened using metal HVAC screens as originally approved in ADS-01-170

APPROVED BY PLANNING
mgliegate 4/20/12

1013.5 Mechanical equipment. *Guards* shall be provided where appliances, equipment, fans, roof hatch openings or other components that require service are located within 10 feet (3048 mm) of a roof edge or open side of a walking surface and such edge or open side is located more than 30 inches (762 mm) above the floor, roof or grade below. The *guard* shall be constructed so as to prevent the passage of a sphere 21 inches (533 mm) in diameter. The *guard* shall extend not less than 30 inches (762 mm) beyond each end of such appliance, equipment, fan or component.

ROOF PLAN NOTES

1. GENERAL CONTRACTOR SHALL COORDINATE WITH THE DIFFERENT TRADES FOR ROOF PENETRATIONS PRIOR TO INSTALLATION OF ROOF MEMBRANE.
2. GENERAL CONTRACTOR TO COORDINATE ROOF CURBS FOR MECHANICAL EQUIPMENT WITH MECHANICAL CONTRACTOR PRIOR TO INSTALLATION WITH EACH UNIT.
3. HVAC UNITS TO BE LOCATED AS INDICATED ON ROOF PLAN AND SHALL BE COORDINATED WITH STRUCTURAL ENGINEER PRIOR TO INSTALLATION IF IT EXCEEDS DESIGN LOAD ALLOWANCE OF 1000 LBS. PER UNIT.
4. ALL GAS AND ELECTRICAL PIPING AND CONDUIT SHALL BE RUN BELOW ROOF. NO ROOF JACKS PERMITTED.

CONSTRUCTIONS NOTES:

1. CONDENSATE DRAIN TO BE DETERMINED BY G.C.
2. GAS PIPING TO BE DETERMINED BY G.C.

This plan to show Approx. locations of Condensor Roof top Units Only

RECEIVED
APR 12 2012
DEVELOPMENT SERVICES COUNTER

Air Conditioning
Heating
Controls
Sales
Service
Installation
"QUALITY ASSURED"

pacific air control, inc.

11812 Northcreek Parkway N., Suite 104
Bothell, WA 98011
ph. (206) 682-6393 fax: (206) 340-2270
Contractor's License No.: PACIFAC230P8

www.pacificaircontrol.com

PROPOSED PROJECT FOR:

BARTELL WESTGATE

23028 100 th AVE
EDMONDS, WA 98020

NO	DATE	DESCRIPTION
	5-7-02	PRELIMINARY
	5-20-02	PERMIT ISSUE
△		
△		
△		
△		

THIS DRAWING IS THE SOLE PROPERTY OF PACIFIC AIR CONTROL, INC. ANY REPRODUCTION, DUPLICATION, ADDITIONS AND/OR MODIFICATIONS REQUIRE THE WRITTEN APPROVAL OF PACIFIC AIR CONTROL, INC.

PROJECT MANAGER: ED GOETZ	DESIGNED BY: GOETZ/NG
DRAWN BY: S. KINGSHOTT	CHECKED BY:
SCALE: ON DRAWING	PROJECT NO.: T020507

DRAWING TITLES

INSTALL ONE 15 TON AND ONE 17½ TON ROOFTOP PKG UNITS TO SERVE MAIN STORE AND ONE 3 TON ROOFTOP PKG UNIT TO SERVE THE PHARMACY. INSTALL FOUR EXHAUST FANS, ONE AIR CURTAIN AND ONE UNIT HEATER.

FILE: BARTELL\WESTGATE EDMONDS\PAC

SHEET NUMBER: 2 of 2

APPROVED PLANS
M-2
3 of 3

COPYRIGHT © 2001 PACIFIC AIR CONTROL INC.

BLD 2012-0264

Bartell Drugs

Quotation

Quote #: 179550
Quote Date: 03/16/2012
Revision: 03/19/2012(#1)

CrownTonka WALK-INS

Box description: COOLER/FREEZER COMBO BOX

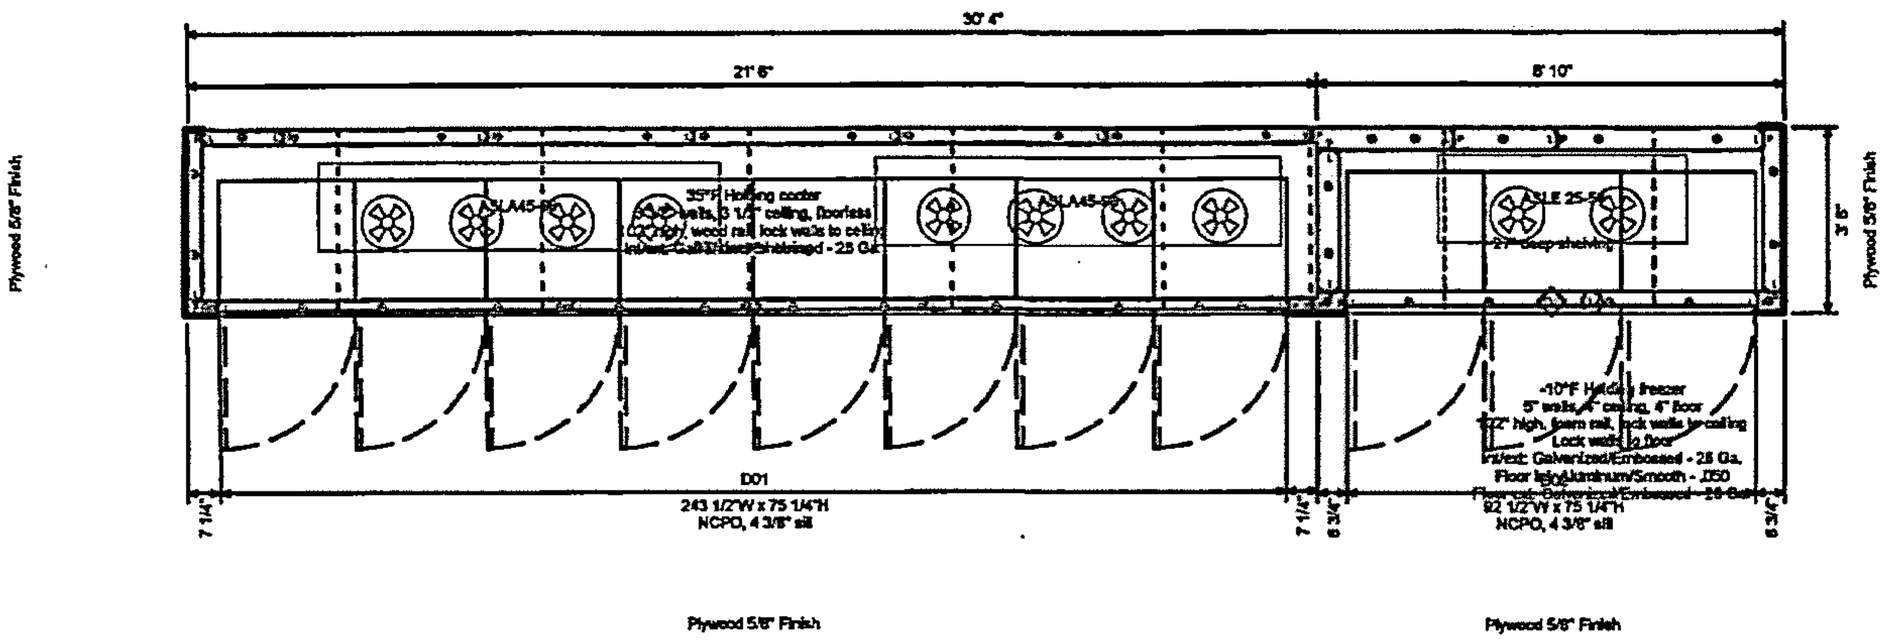

☐ Approved as submitted

☐ NOT APPROVED – Revise and resubmit for approval

Before signing this document, verify that the content you are signing is correct.

X

Accepted By: Date:

RECEIVED
APR 12 2012
DEVELOPMENT SERVICES COUNTER

CITY COPY

Bartell Drugs

Quotation

Quote #: 179550
Quote Date: 03/16/2012
Revision: 03/19/2012(#1)

Box description: COOLER/FREEZER COMBO BOX -- Front elevation

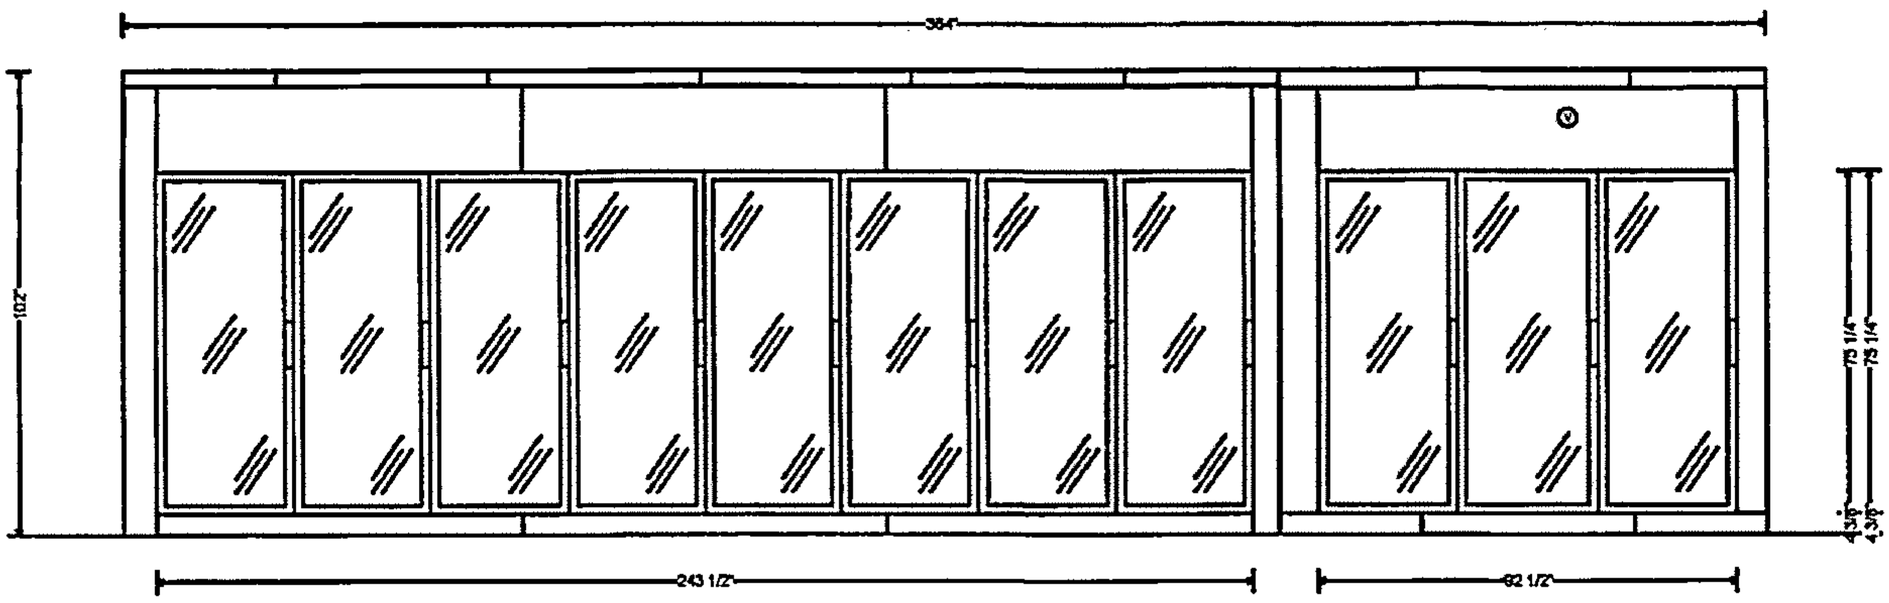

☐ Approved as submitted

☐ NOT APPROVED – Revise and resubmit for approval

Before signing this document, verify that the content you are signing is correct.

X

Accepted By: Date:

Bartell Drugs

Quotation

Quote #: 179550
Quote Date: 03/16/2012
Revision: 03/19/2012(#1)

CrownTonka WALK-INS

Box description: COOLER/FREEZER COMBO BOX

Dimensions:

External (O.D.): 30' 4" x 3' 6" x 8' 6" - w x d x h
Internal (I.D.): 29' 7 5/8" x 2' 11 1/4" x 8' 2 5/8" - w x d x h
Volume: 715 ft³

Finishes

Walls: Galvanized/Embossed - 26 Ga. - interior
Galvanized/Embossed - 26 Ga. & Plywood 5/8" Finish - exterior
Floors: Aluminum/Smooth - .050 - interior
Galvanized/Embossed - 26 Ga. - exterior
Ceilings: Galvanized/Embossed - 26 Ga. - interior & exterior

Panel Thickness

Walls: 3.5" & 5" UL Listed Class 1 Foam
Floors: 4" UL Listed Class 1 Foam standard floor 1000 lb/ft² equally distributed (single layer of underlayment in floor)
Ceilings: 3.375" & 4" UL Listed Class 1 Foam

Qty	Description
	<u>Openings</u>
1	D02: CDS Advantage glass door, NCPO 92 1/2"W x 75 1/4"H (3 x 30"Wx75"H), 4 3/8" sill
	<u>Accessories</u>
2	Light- 1806 (120v) Vapor-Proof Compact Fluorescent Globe fixture w/bulb (Ship Loose)
1	Vent - 115v Hi-Flow Heated Pressure Relief Port (Kason 1832)
10	Lock Wall Panels to Floor Panels
41	Lock Wall Panels to Ceiling Panels (Factory Ceiling Caps - Standard)

Qty	Description
1	D01: CDS Advantage glass door, NCPO 243 1/2"W x 75 1/4"H (8 x 30"Wx75"H), 4 3/8" sill
2	Ceiling Hanger Brackets (no rods) - wood frame
2	Header Brace Bracket - Standard
9	Caulk - Butyl (Tubes)

Bartell Drugs

Quotation

Quote #: 179550
Quote Date: 03/16/2012
Revision: 03/19/2012(#1)

Refrigeration

Condensing Unit for Holding freezer

- Manufacturer: Russell
- Description: Low Temp R404A Air Cooled Hermetic Remote Outdoor Condensing Unit
- Model: RLH165L44
- Horsepower: 1.5hp
- Extras: Defrost timer included. Drier and Sight glass mounted (timer not mounted on 1/2 to 2 hp med temp units).
- Electrical: 230/1/60, RLA 11.4, MOPD N/A, MCA 18
- Conditions: BTUH: 5670 Room Temp: -10°F Ambient: 95°F
- Warranty: Compressor-motor warranty extended to 5-years, parts only, no labor

1 x Evaporator (Unit cooler)

- Manufacturer: Russell
- Description: Electric defrost Reach-in style coil
- Model: ASLE 25-58
- Extras: with expansion valve solenoid and thermostat shipped loose ECM fan motors
- Electrical: 230/1/60, Fan amps 1.1, Defrost amps 8.6

Condensing Unit for Holding cooler

- Manufacturer: Russell
- Description: Med Temp R404A Air Cooled Hermetic Remote Outdoor Condensing Unit
- Model: RLH251M44
- Horsepower: 1.75hp
- Extras: Defrost timer included. Drier and Sight glass mounted (timer not mounted on 1/2 to 2 hp med temp units).
- Electrical: 230/1/60, RLA 11.2, MOPD N/A, MCA 16
- Conditions: BTUH: 18130 Room Temp: 35°F Ambient: 95°F
- Warranty: Compressor-motor warranty extended to 5-years, parts only, no labor

2 x Evaporator (Unit cooler)

- Manufacturer: Russell
- Description: Air defrost Reach-in style coil
- Model: ASLA45-98
- Extras: with expansion valve solenoid and thermostat shipped loose ECM fan motors
- Electrical: 115/1/60, Fan amps 4.4, Defrost amps N/A

Disclosure:

- All quotations and order shall be subject to CrownTonka, division of Crown Fixtures, Inc. standard terms and conditions notwithstanding any additional or contrary terms and conditions of Buyer. Such additional or contrary terms shall not bind Crown Fixtures unless accepted in writing even though such terms do not materially alter the terms hereof. No oral statements, warranties, stipulations, representations or terms shall have binding effect or be any part of the contract whatsoever. All orders must be in writing and will be binding when our order acknowledgement is mailed, faxed or emailed. If customer does not have a copy of these terms and conditions, please contact the customer service department.
- Price quotations are valid for 30 days from quote date shown on printout.
- Terms: subject to credit approval.
- Quoted price DOES NOT include any applicable sales tax. Ask your customer service representative for a list of states in which sales tax is collected. If item is resale, a copy of your resale exemption certificate must be on file with CrownTonka prior to shipping, otherwise sales tax may be charged.
- All shipments to IA are subject to use tax per the Iowa code. Resale certificates do not apply.
- Lead Times vary depending on the production schedule. Please consult you customer service representative for an actual lead-time.
- Structural or seismic calculations and materials are not included unless shown on quote or requested.

We hope this quotation meets with your approval and if we can be of further assistance please do not hesitate to contact your customer service representative. Thank you for the opportunity to submit this quotation.

Please include the quotation reference number with all enquires pertaining to this document.

Sincerely,

Customer Service Department